




REARING HOUSE LAYOUT
SCALE 1:200

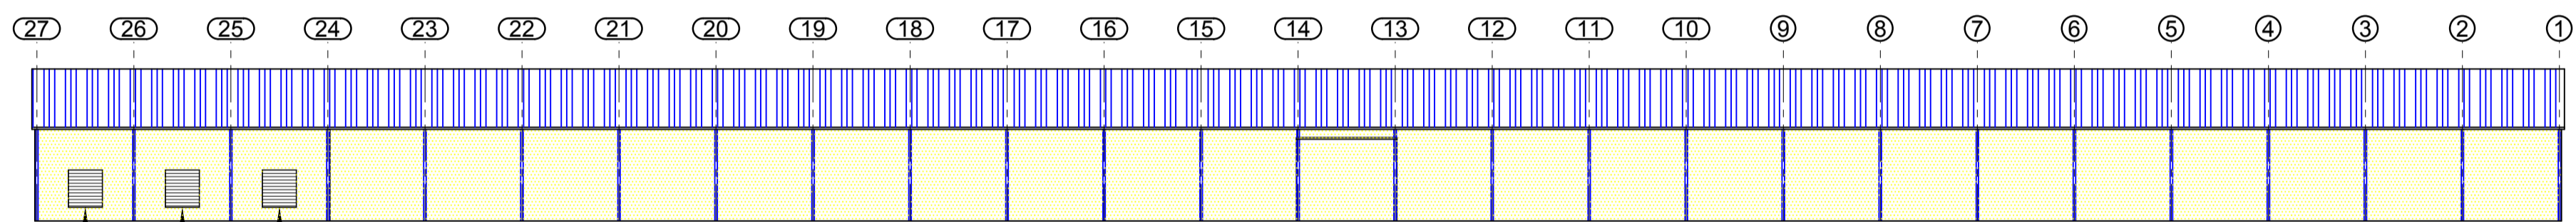


SOUTH ELEVATION
SCALE 1:200

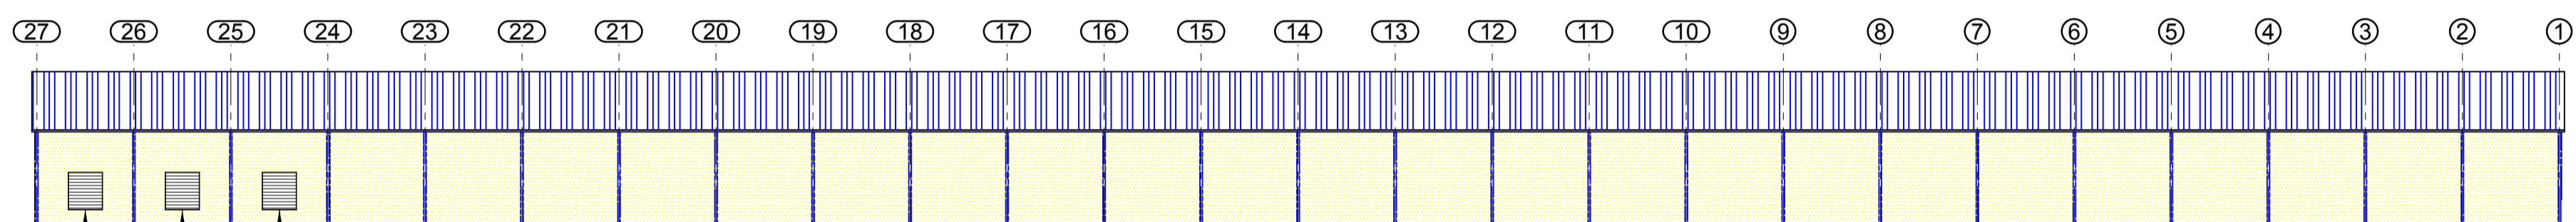

NORTH ELEVATION
SCALE 1:200

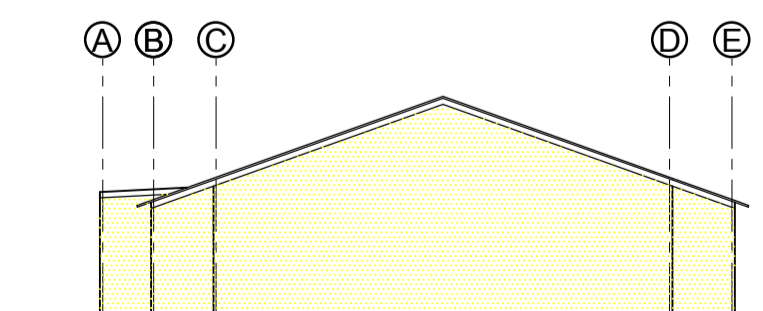

EAST ELEVATION
SCALE 1:200

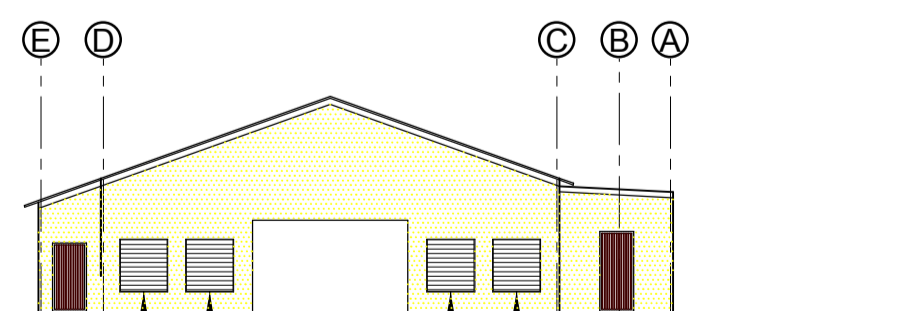

WEST ELEVATION
SCALE 1:200

10/04/2017	01 AS BUILT	JVL
DATE	REVISION	BY

NOTE:
COPYRIGHT IS VESTED IN THIS DOCUMENT AND NO USE OR REPRODUCTION OR DUPLICATION THEREOF MAY OCCUR WITHOUT THE WRITTEN CONSENT OF THE AUTHOR

CLIENT
QUANTUM FOODS(PTY) LTD
T/A TYDSTROOM MOREDOU
BREEDERS

PROJECT
PART 27 OF FARM 73, HALFGewaagd,
Tulbach

TITLE
REARING HOUSES
LAYOUT & ELEVATIONS



SKCMasakhizwe Engineers
CONSULTING ENGINEERS TO BUILD THE NATION
13 PASTORIE AVENUE
PO BOX 229
FAARL
7620
TEL: (021) 871 1422/3
FAX: (021) 872 7740
9B CHURCH STREET
PO BOX 63
MALMESBURY
7300
TEL: (022) 487 3017
eMail: skcmsouth@skcm.co.za

ARCHITECTS

DESIGNED JVL	DRAWN JVL	APPROVED M LOUBSER PrEng 880632
DATE 10/04/2017	SCALE AS SHOWN	

DRAWING NUMBER W1655-10	REVISION 01
----------------------------	----------------